

11-DEC-2012 14:37

Chad. Havens

TIME\$\$\$ 006043ST28-1A  
8825Full.pen



R:\07400004\006043\GDN\As Bullets\GDN\006043ST28-1A.dgn

STATE GA PROJECT NUMBER CSNHS-0006-00(043)  
SHEET NO. 129 TOTAL SHEETS 668

## AS-BUILT PLANS 12/12/12

DRAFT

DRAWING NO. 19-028

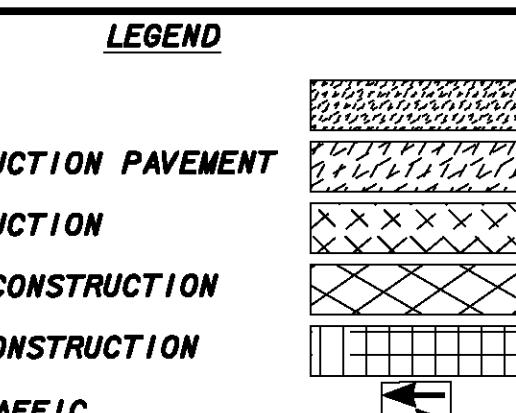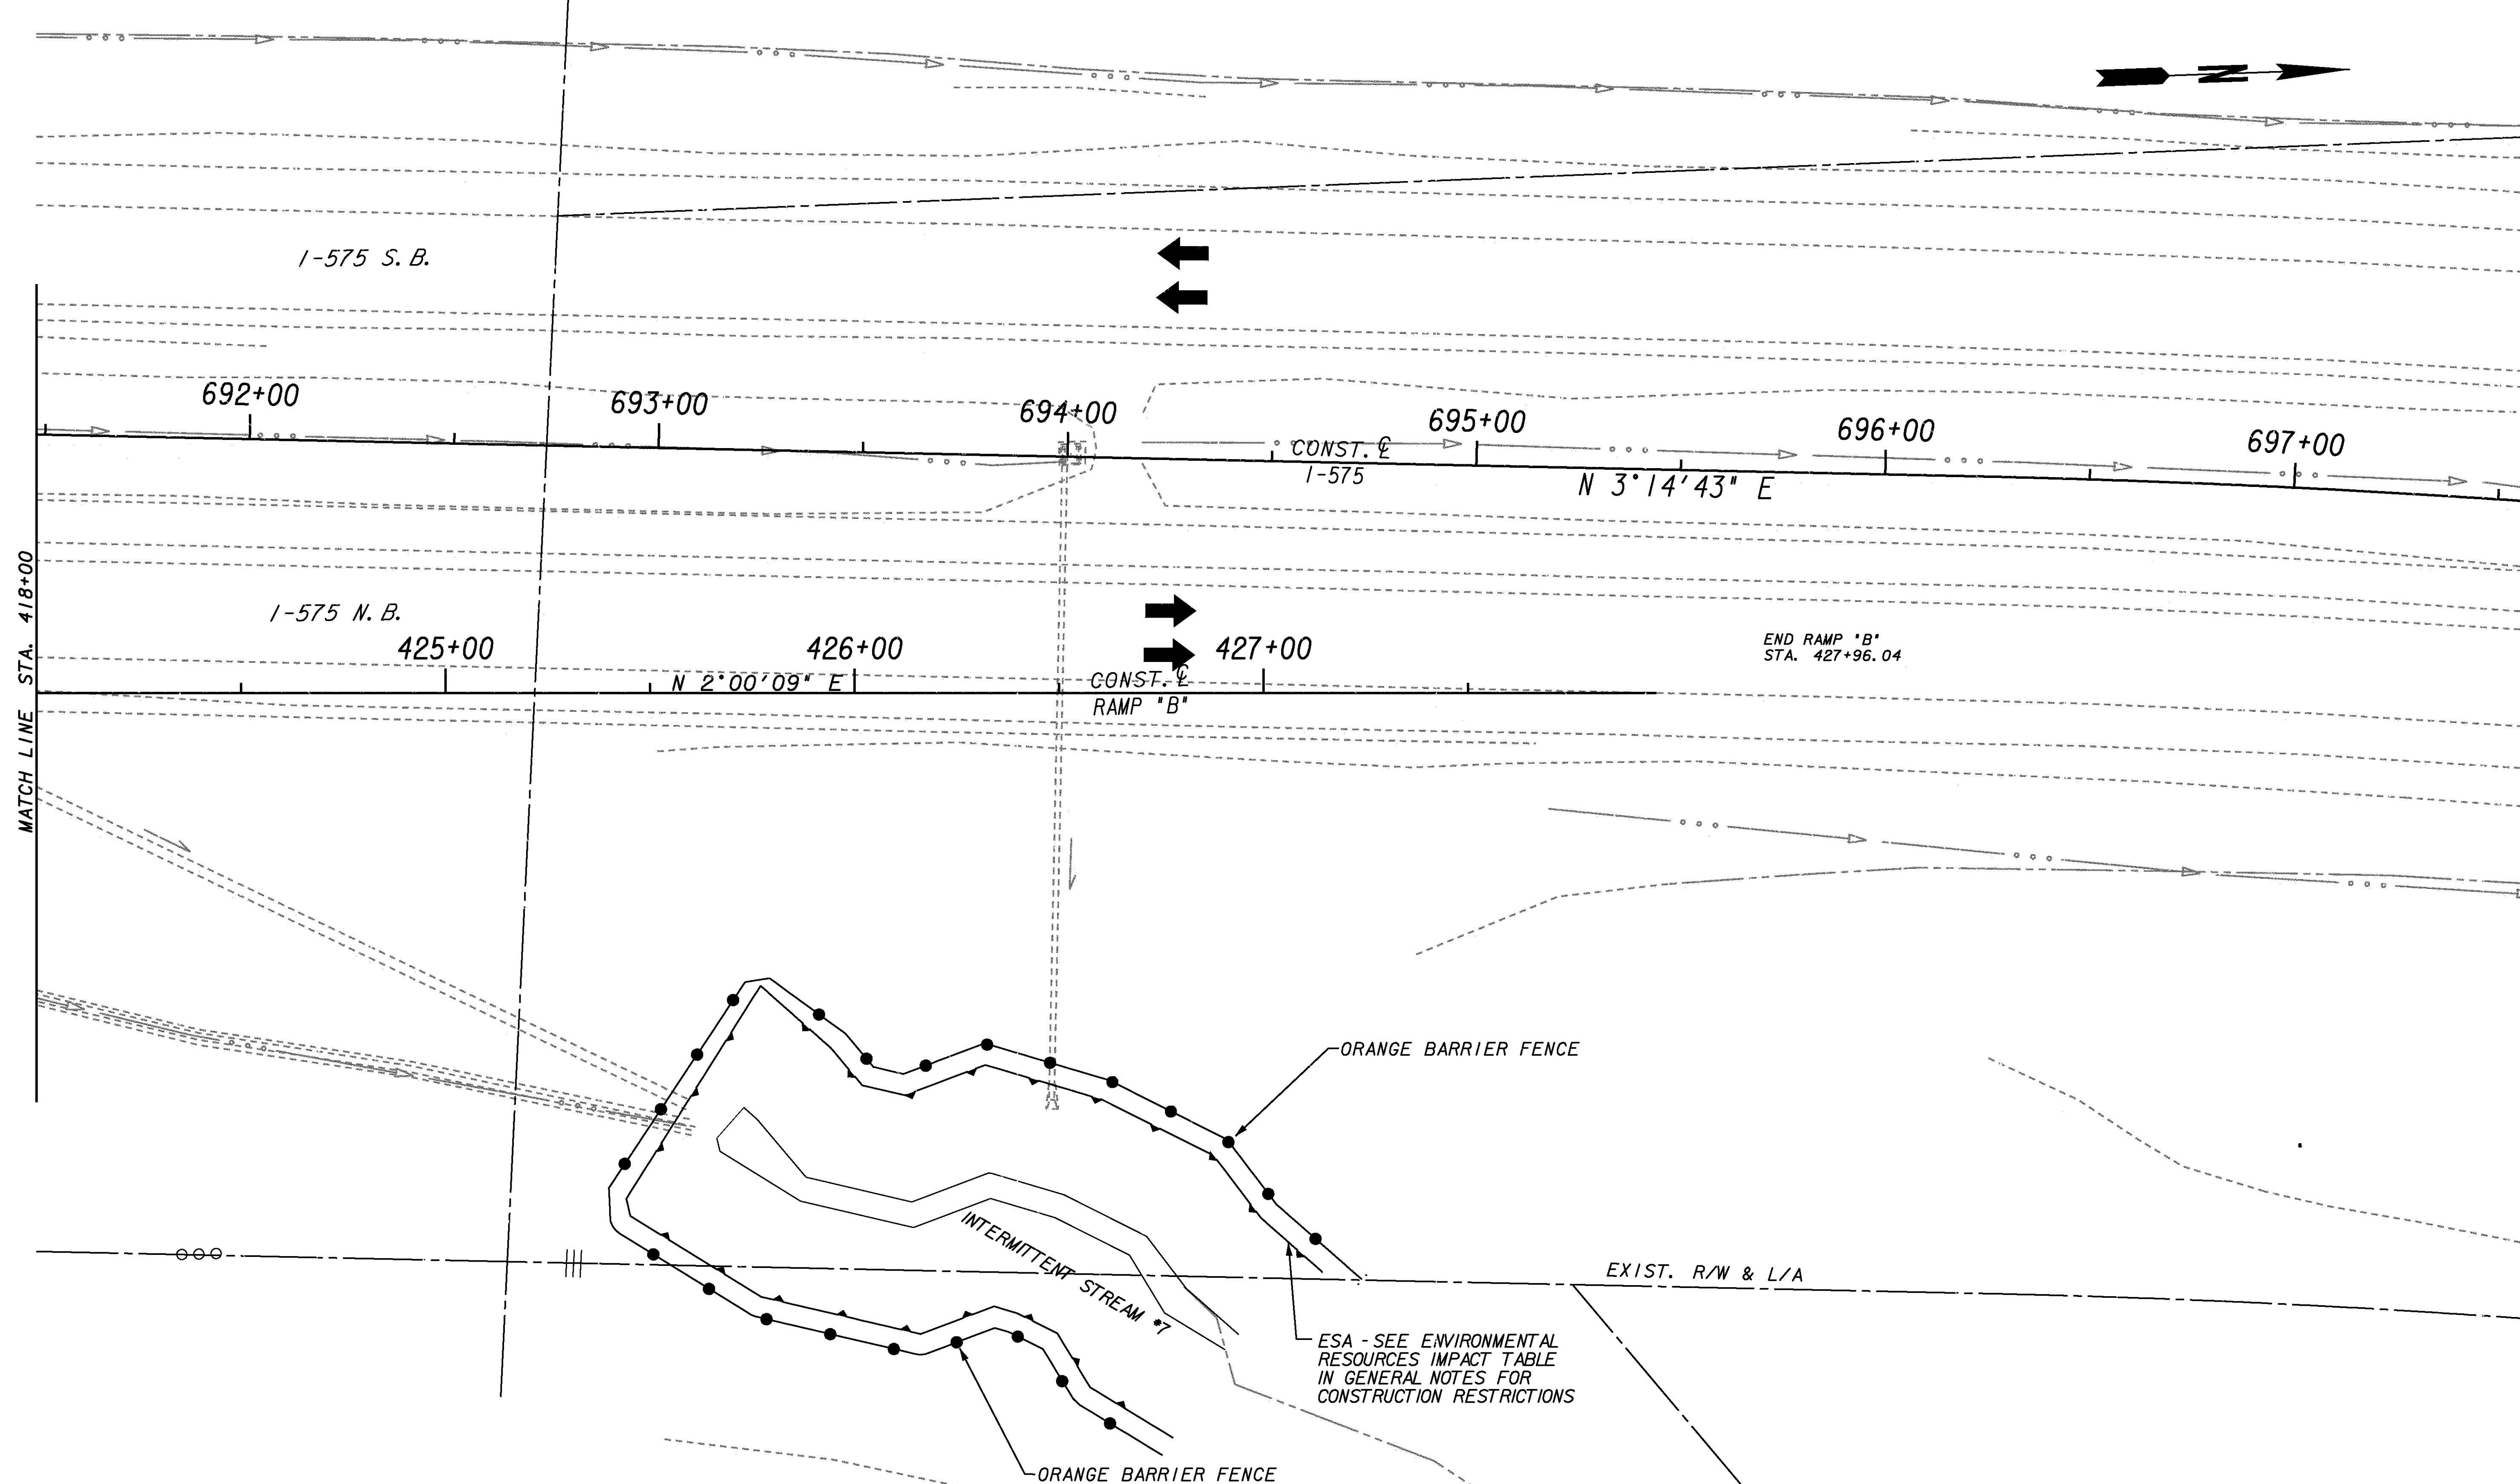

STAGE 1 PHASE 1

THE  
LPA  
GROUP  
TRANSPORTATION CONSULTANTS  
3595 ENGINEERING DRIVE  
NORCROSS, GEORGIA 30092  
(770) 263-9118



REVISION DATES	

STATE OF GEORGIA  
DEPARTMENT OF TRANSPORTATION  
OFFICE: INNOVATIVE PROGRAM DELIVERY  
**CONSTRUCTION STAGING PLAN**  
I-575 NB ENTRANCE RAMP B  
STA. 418+00 TO END CONST.  
DRAWING NO. 19-028